


SHEET No 23 2488 A (MOUNT JOY)
LANDS OF DEVIN

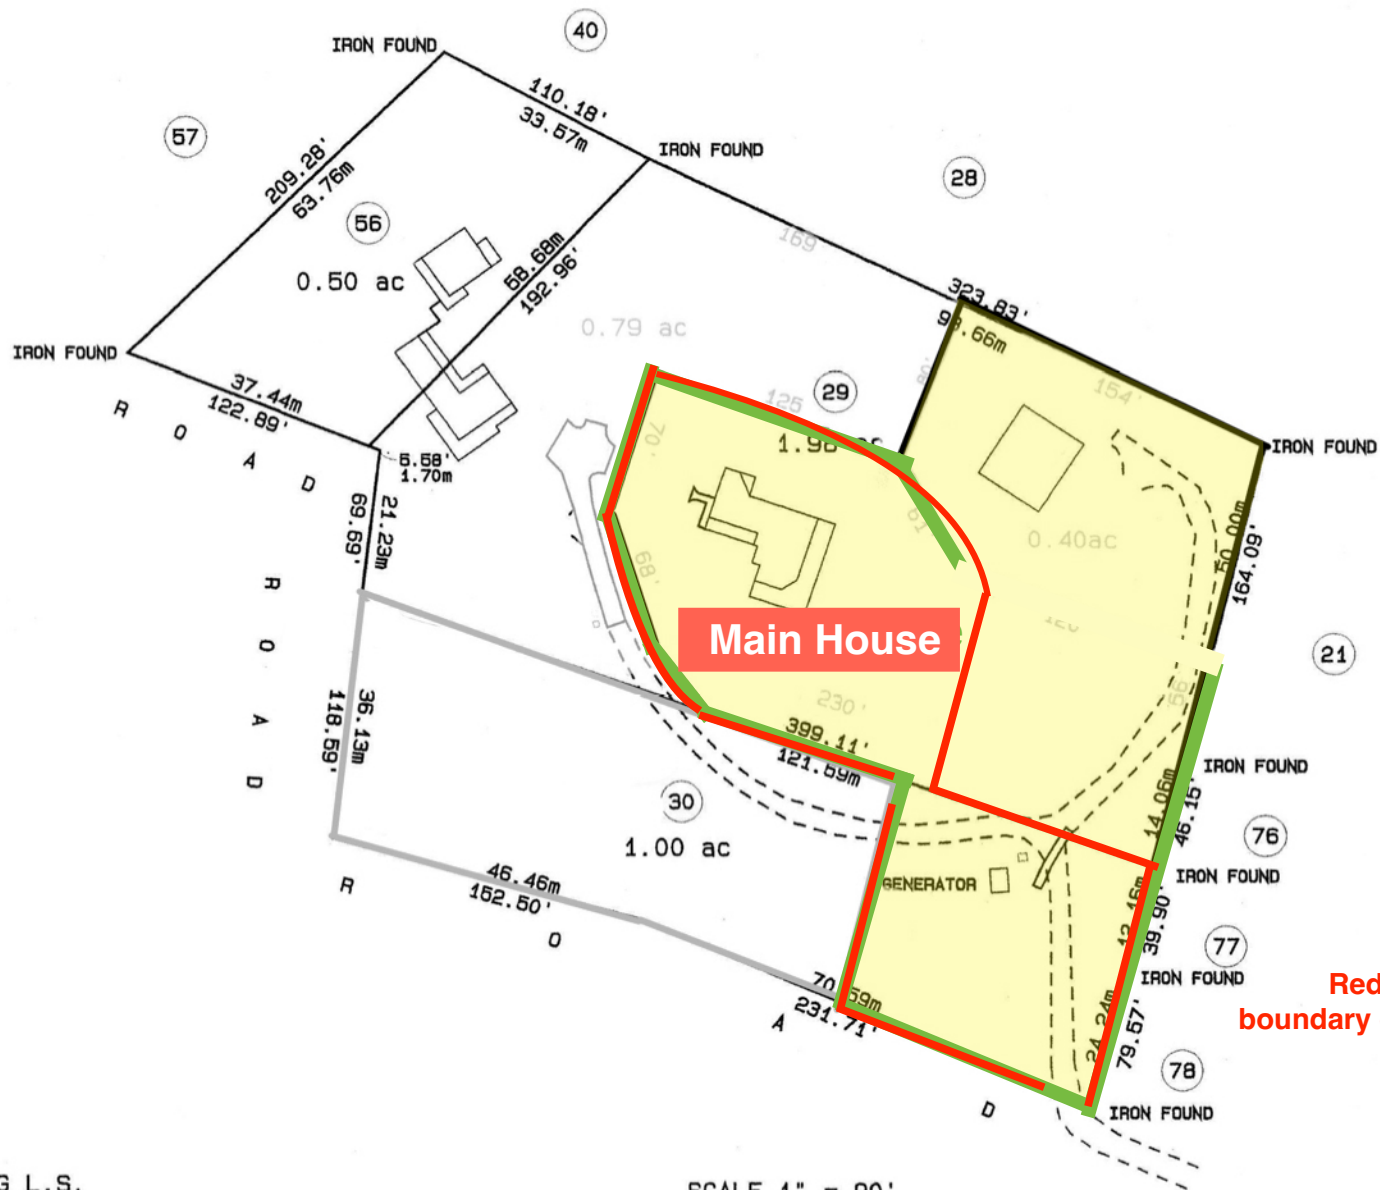

Red line shows
boundary of the Main House